


Plan Example



SERVICES AS LAID PLAN

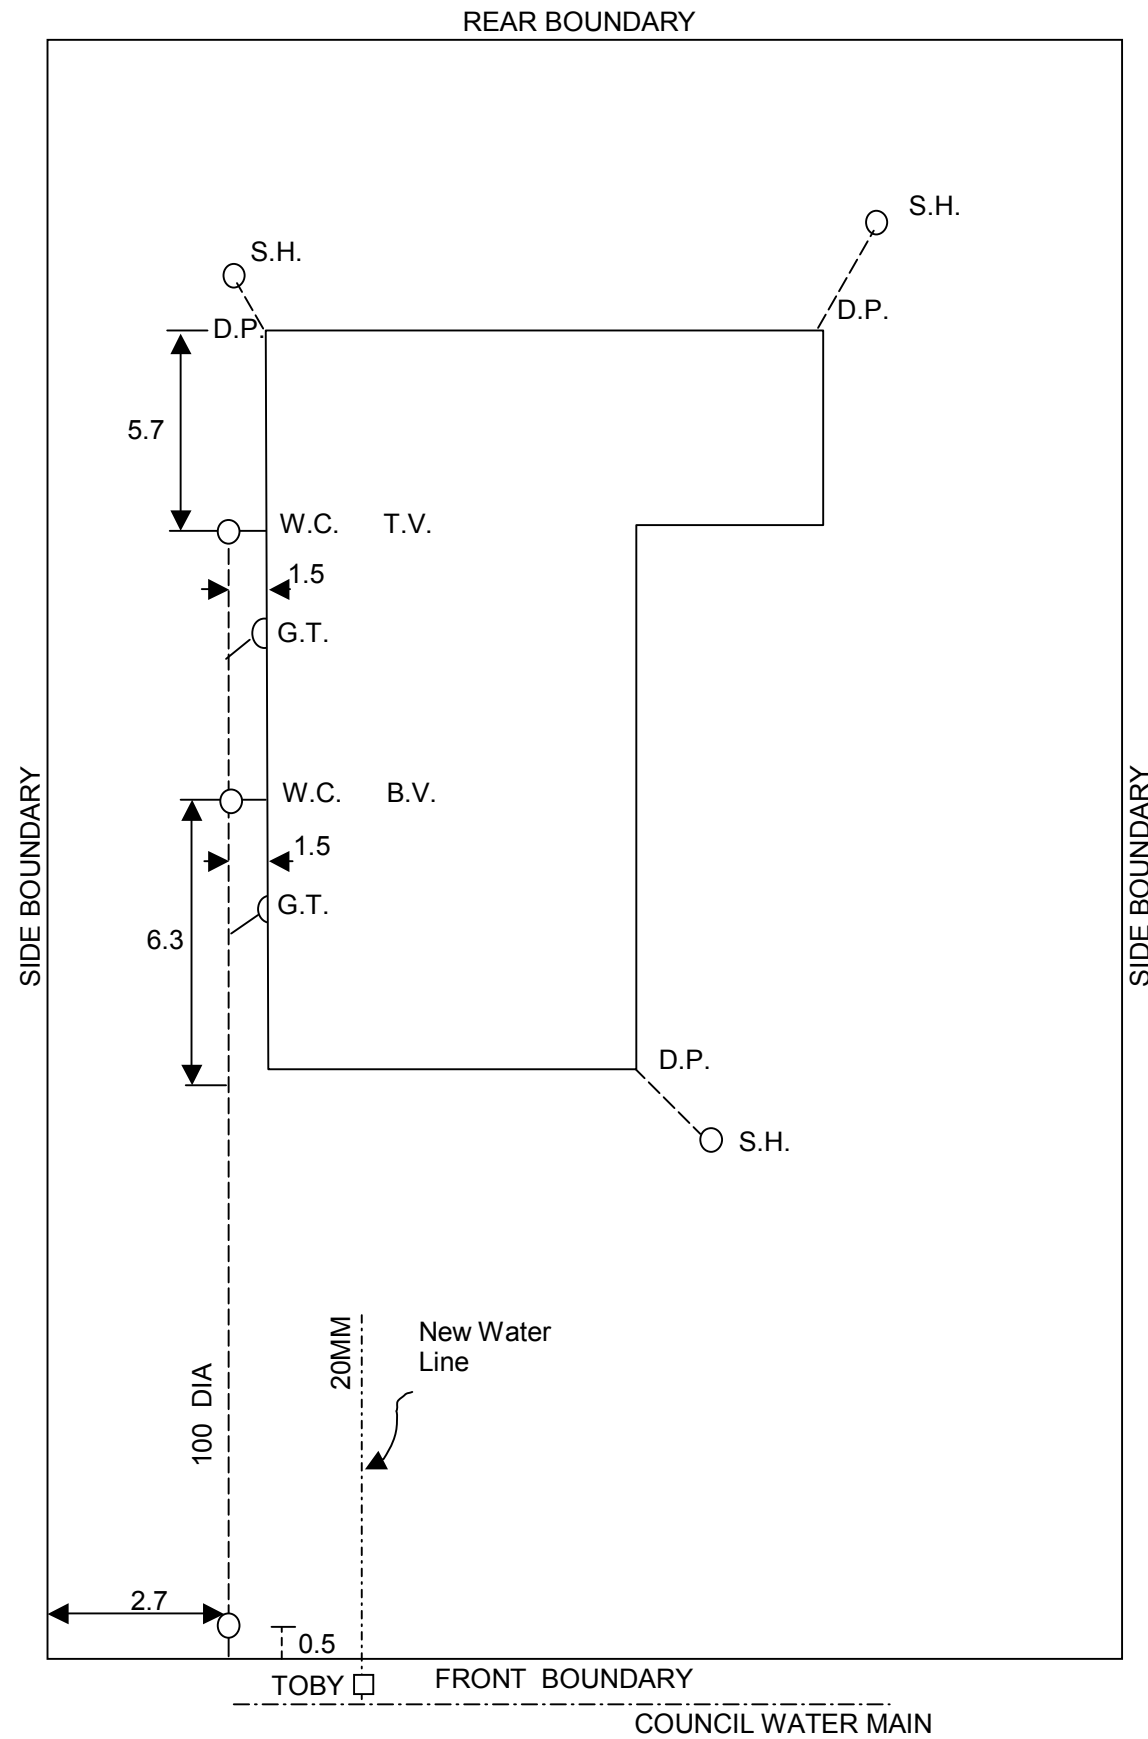

CONSENT NUMBER

As Laid Plan for:

OWNER NAME

PROJECT LOCATION

| Rural ID/ Street No. | Address | Locality |
|-------------------------|----------------------|----------------------|
| <input type="text"/> | <input type="text"/> | <input type="text"/> |

DETAILS - PLUMBER & DRAINLAYER


| | |
|----------------------|----------------------|
| <input type="text"/> | <input type="text"/> |
|----------------------|----------------------|

DRAW PLAN IN BLACK BALLPOINT ON GRAPH OPPOSITE

PLAN is to show:

1. All drains in correct position relative to building and boundaries.
2. The road frontage
3. Depth of drains at connection points
4. All foulwater and stormwater drains.
5. All inspection openings, accurately dimensioned.
6. All buildings and boundaries.
7. Outside mainwater lines and the source supply.

REFER TO EXAMPLE ON LAST PAGE

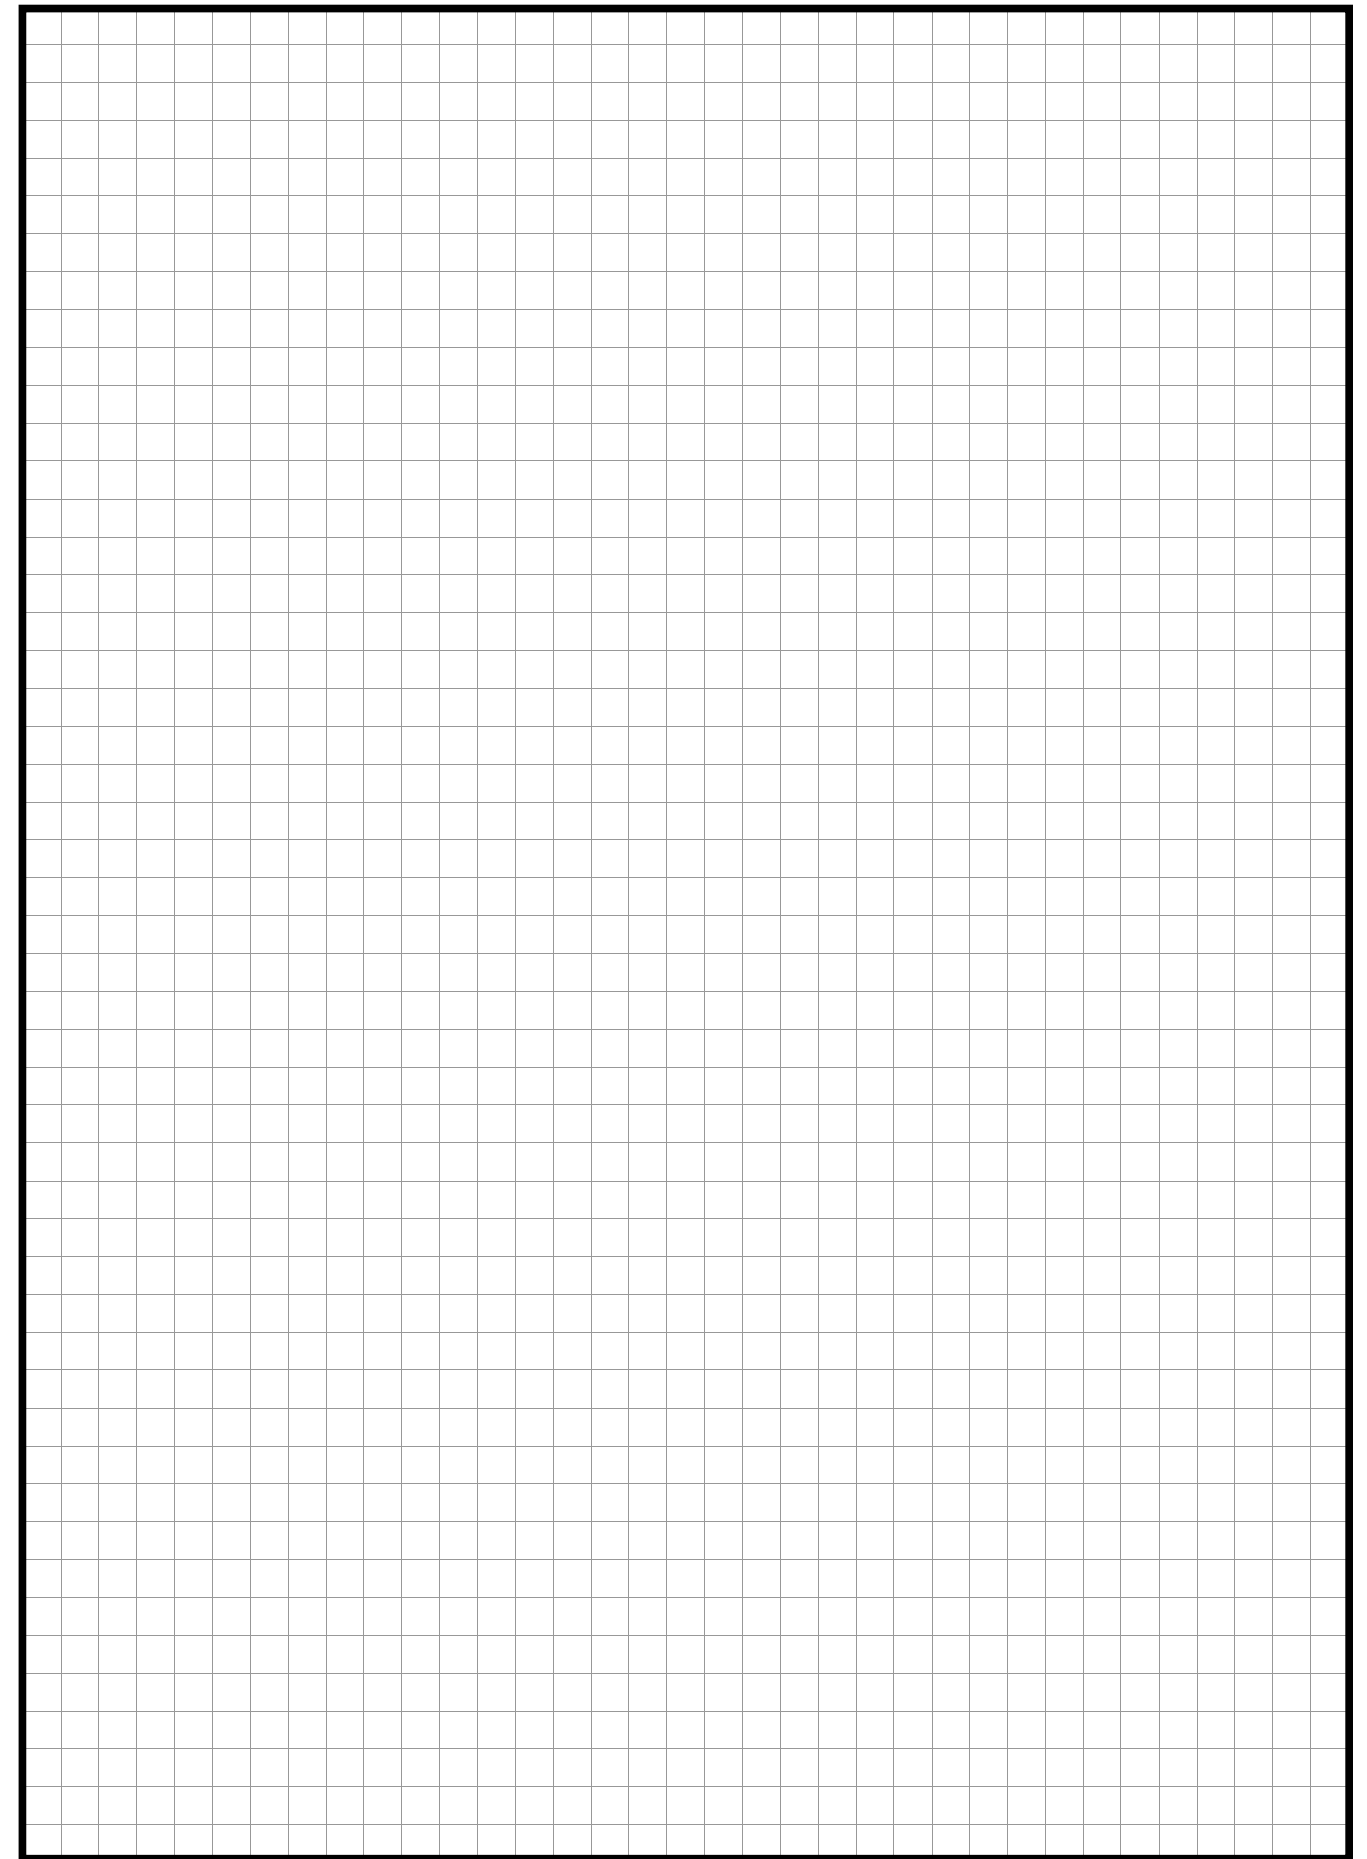

CHECKED BY:

| | |
|------------|-------|
| Inspector: | Date: |
|------------|-------|